

*Date: Tuesday, 8/1/2006 11:58:43 AM
User: Kim Johnston

Process Sheet

Customer : CU-DAR001 Dart Helicopters Services	Drawing Name : BASKET (A119) ARMS
Job Number : 27982	
Estimate Number : 12443	
P.O. Number : N/A	Part Number : D3518041
This Issue : 8/1/2006 S.O. No. : N/A	Drawing Number : D3518 PRELIMINARY B
Prsht Rev. : NC	Project Number : N/A
First Issue : 7/19/2006 Type : R & D SM/MED FAB	Drawing Revision : A PRELIMINARY
Previous Run : 27695	Material : N/A
Written By : <u>See Comment Below</u>	Due Date : 7/26/2006 Qty: 2 Um: Each
Checked & Approved By : <u>06.08.01</u>	
Comment : EST rev. A 06.06 preliminary EC	

Additional Product

Job Number:



Seq. #:	Machine Or Operation:	Description :
---------	-----------------------	---------------

1.0	D23245	Strap
-----	--------	-------



Comment: Qty.: 2.0000 Each(s)/Unit Total : 4.0000 Each(s)
Strap
batch: 25048B

2.0	D35181	FWD ARM
-----	--------	---------



Comment: Qty.: 1.0000 Each(s)/Unit Total : 2.0000 Each(s)
FWD ARM
Batch: 27983

3.0	59915K24	SS BALL JOINT ROD END
-----	----------	-----------------------



Comment: Qty.: 1.0000 (s)/Unit Total : 2.0000 (s)
SS BALL JOINT ROD END
Batch: 1101635

4.0	AN313A	Bolt
-----	--------	------



Comment: Qty.: 2.0000 Each(s)/Unit Total : 4.0000 Each(s)
Bolt
Batch: 9967

5.0	AN960JD10	Washer
-----	-----------	--------



Comment: Qty.: 4.0000 Each(s)/Unit Total : 8.0000 Each(s)
Washer
Batch: 100743

W/O:		WORK ORDER CHANGES					
DATE	STEP	PROCEDURE CHANGE	By	Date	Qty	Approval Mfg / Design Mgr	Approval QC Inspector

NCR:		WORK ORDER NON-CONFORMANCE (NCR)						
DATE	STEP	Description of NC Section A	Corrective Action Section B		Sign & Date	Verification Section C	Approval Design Mgr	Approval QC Inspector
			Initial Design Mgr	Action Description Design Mgr				

Part No: _____ PAR #: _____ Fault Category: _____ NCR: Yes ☒ No ☐ DQA: ☒ _____ Date: 06/08/02

NOTE: Date & initial all entries

QA: N/C Closed: _____ Date: _____

Date: Tuesday, 8/1/2006 11:58:43 AM
User: Kim Johnston

Process Sheet

Customer: CU-DAR001 Dart Helicopters Services

Drawing Name: BASKET (A119) ARMS

Job Number: 27982

Part Number: D3518041

Job Number:



Seq. #:

Machine Or Operation:

Description :

6.0

MS21042L3

Nut



Comment: Qty.: 2.0000 Each(s)/Unit Total : 4.0000 Each(s)

Nut

Batch: 100094

13 (01)

7.0

AN316C6R

Nut



Comment: Qty.: 1.0000 Each(s)/Unit Total : 2.0000 Each(s)

Nut

BATCH: #17260

13 (2)

8.0

SMALL FAB 1

SMALL & MEDIUM FAB RESOURCE 1



Comment: SMALL & MEDIUM FAB RESOURCE 1

Assemble as per dwg D3518

13 (2) 06.08.02 (2)

9.0

QC5

INSPECT WORK TO CURRENT STEP



Comment: INSPECT WORK TO CURRENT STEP

06.08.02 (2)

10.0

PACKAGING 1

PACKAGING RESOURCE #1



Comment: PACKAGING RESOURCE #1

Identify with Part # D3518-041 using fine point permanent ink marker and Stock

Location: _____

With tag.

11.0

DC

DOCUMENT CONTROL



Comment: DOCUMENT CONTROL

Inspection Level 21

(2)
06/08/02.

Job Completion



W/O:		WORK ORDER CHANGES					
DATE	STEP	PROCEDURE CHANGE	By	Date	Qty	Approval Mfg / Design Mgr	Approval QC Inspector

NCR:		WORK ORDER NON-CONFORMANCE (NCR)						
DATE	STEP	Description of NC Section A	Corrective Action Section B		Sign & Date	Verification Section C	Approval Design Mgr	Approval QC Inspector
			Initial Design Mgr	Action Description Design Mgr				

Part No: _____ PAR #: _____ Fault Category: _____ NCR: Yes No DQA: _____ Date: _____


NOTE: Date & initial all entries

QA: N/C Closed: _____ Date: _____

PRELIMINARY ISSUE

06.07.19

DESIGN B	DRAWN BY B	DART AEROSPACE LTD HAWKESBURY, ONTARIO, CANADA	
CHECKED	APPROVED	DRAWING NO. D3518	REV. B SHEET 1 OF 2
DATE 06.07.17	TITLE BASKET (A119) STRUT		SCALE 1:3
A	06.06.21	NEW ISSUE	
B	06.07.17	RE-DESIGN	

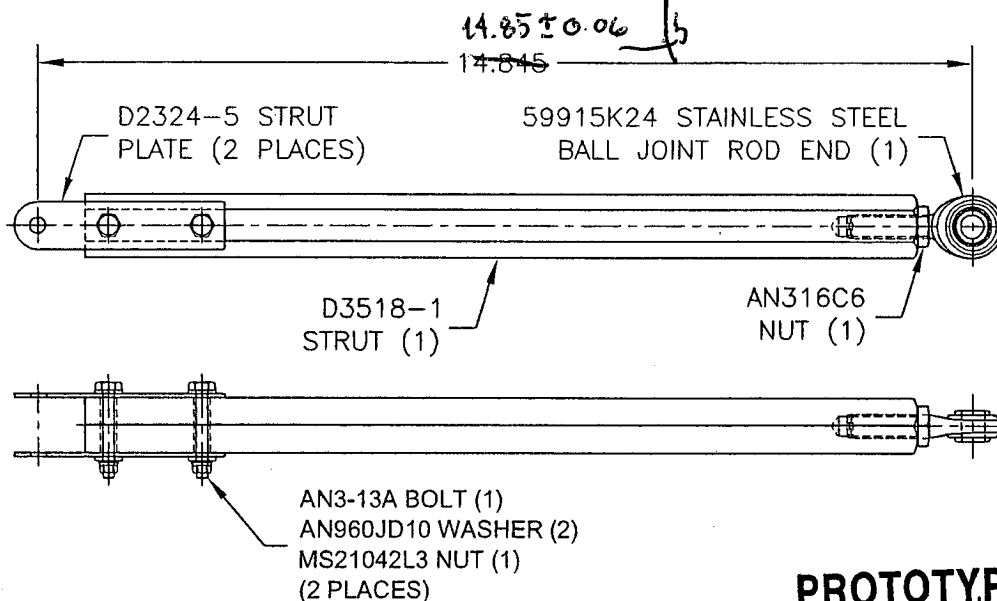

PROTOTYPE
PLEASE RETURN ALL ISSUED
DATA TO ENGINEERING
06.07.19

D3518-041 STRUT ASSEMBLY

QTY -041	Part Number	Description
X	D3518-041	STRUT ASSEMBLY
2	D2324-5	STRUT PLATE
1	D3518-1	STRUT
1	59915K24	STAINLESS STEEL BALL JOINT ROD END
2	AN3-13A	BOLT
1	AN316C6 R	NUT
4	AN960JD10	WASHER
2	MS21042L3	NUT

NOTES:

- 1) IDENTIFY WITH DART P/N "D3518-041" USING FINE POINT PERMANENT INK MARKER

SHOP COPY
RETURN TO
ENGINEERING
UNCONTROLLED COPY
SUBJECT TO AMENDMENT
WITHOUT NOTICE
WORK ORDER
NO. 27982

Copyright © 2006 by DART AEROSPACE LTD

THIS DOCUMENT IS PRIVATE AND CONFIDENTIAL AND IS SUPPLIED ON THE EXPRESS CONDITION THAT IT IS NOT TO BE USED FOR ANY PURPOSE OR COPIED OR COMMUNICATED TO ANY OTHER PERSON WITHOUT WRITTEN PERMISSION FROM DART AEROSPACE LTD.